

INVITATION TO TENDER ("ITT") NO. PS20200359
CONTRACTOR FOR MONTGOMERY PARK GRASS FIELD RENEWAL

QUESTIONS AND ANSWERS NO. 2


ISSUED ON AUGUST 18, 2020

Q1	Please provide the old irrigation plan of the park?
A1	See attached for details.

A1 195.003

ATTENTION

The Vancouver Park Board assumes no responsibility for the accuracy or completeness of the field information shown on this plan. All work carried out is done wholly at the risk of the party undertaking the work who agrees, as a condition of such undertaking, to release the Vancouver Park Board from all liability. Locations of underground utilities should be confirmed by M-scoping and/or manual digging.

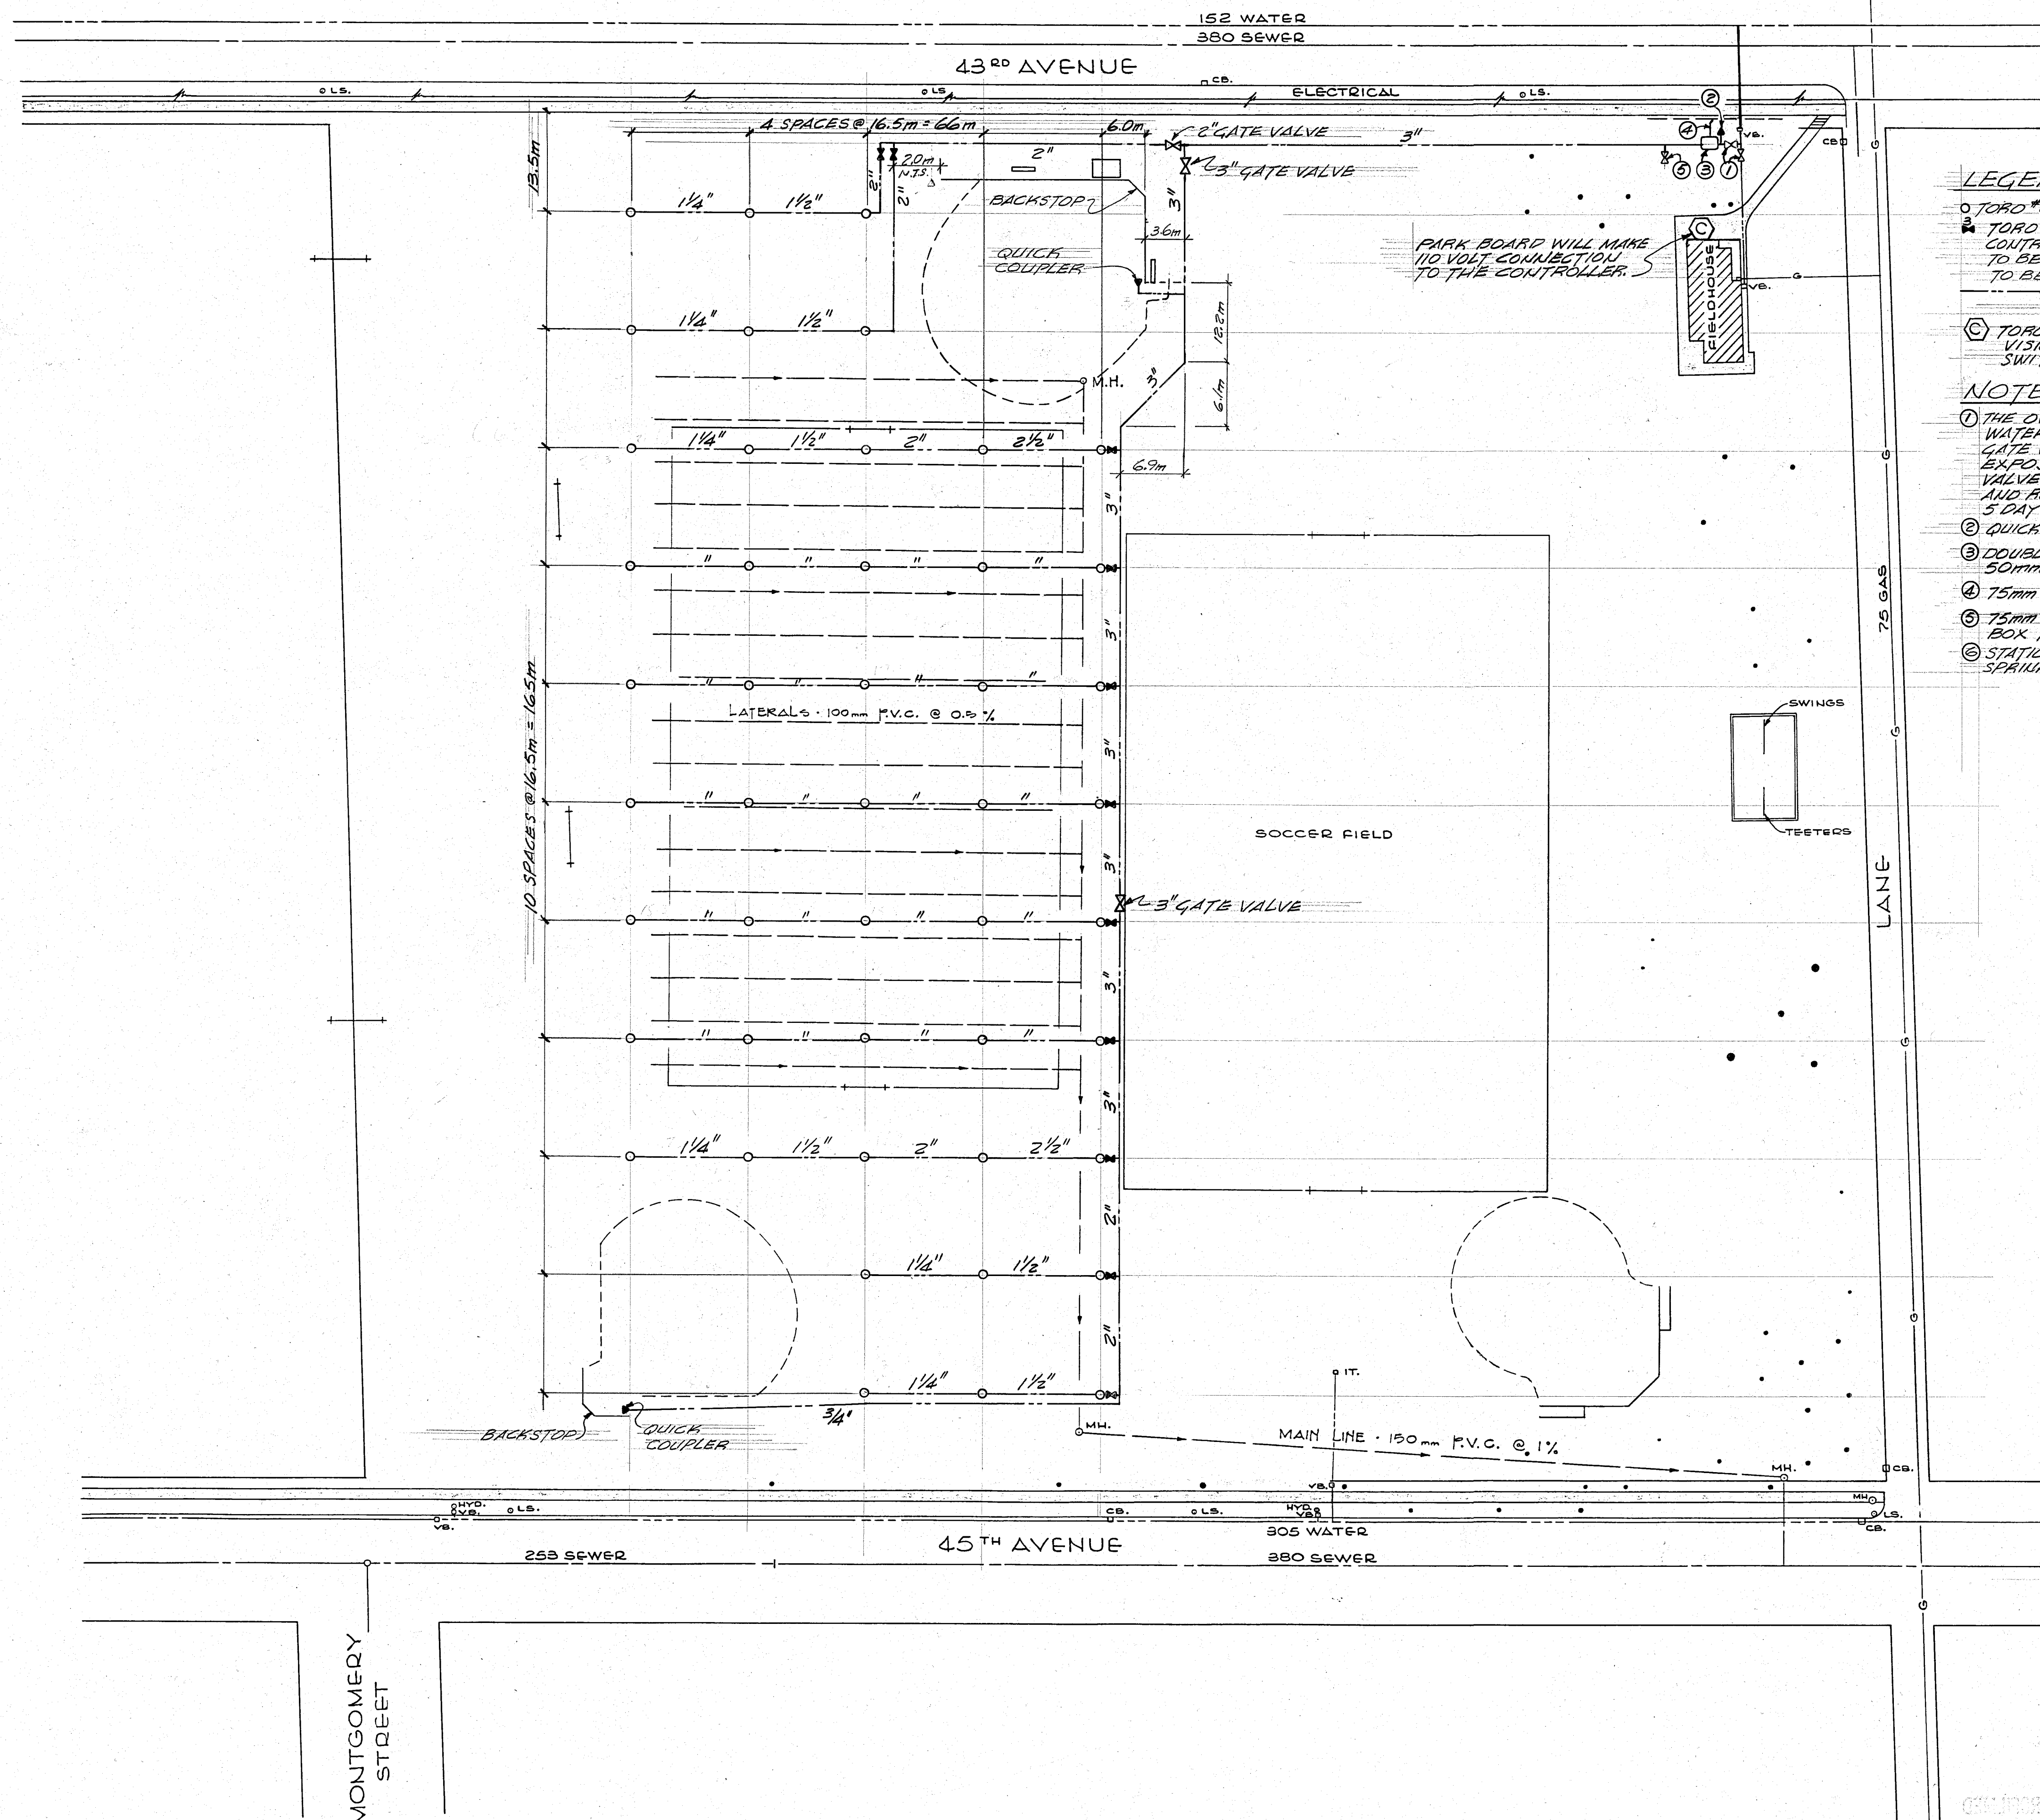

LEGEND

- 0 TORO *644-02-43 SPRINKLER .47" RCPD.
 2 TORO *C52-C6 VALVES. NUMBER INDICATES
 CONTROL VALVE STATION. STATIONS 1, 2, 10 & 11
 TO BE 2" DIA. ALL OTHER STATIONS
 TO BE 2" DIA.
 --- SCHEDULE 40 PVC PIPE SIZES AS
 NOTED.
 (C) TORO CONTROLLER MODEL #189-06-01
 VISION II. INCLUDE A TORO RAIN
 SWITCH AND BYPASS SWITCH.

NOTES.

- ① THE OWNER WILL TIE INTO THE EXISTING WATER SERVICE AND INSTALL 3" BRONZE GATE VALVES. THE CONTRACTOR SHALL EXPOSE THE PIPE, SUPPLY & INSTALL VALVE BOXES PER DWG. #261-085. BACKFILL AND RESTORE TURF. THE OWNER REQUIRES 5 DAYS NOTICE TO INSTALL VALVES & TEE.
- ② QUICK COUPLER (20mm) FOR WINTERIZING.
- ③ DOUBLE CHECK VALVE - CLAYTON MODEL D, 50MM DIAMETER. SEE DWG. #261-086.
- ④ 75mm DRAIN TO SIDEWALK DRAIN SYSTEM.
- ⑤ 75mm BRONZE GATE VALVE IN VALVE BOX FOR FUTURE EXTENSION.
- ⑥ STATIC PRESSURE AT FIELDHOUSE = 60 PSI. SPRINKLER OPERATING PRESSURE = 43-46 PSI.

1	Nov 76	Nov 76	AS-BUILT	
REV.	DATE	BY	DESCRIPTION	C

PLANNING
OPERATIONS
RECREATION
FINANCE
SUPERINTENDENT

**BOARD OF
PARKS AND
RECREATION**
CITY OF VANCOUVER
2099 BEACH AVENUE
V6G-1Z4 TEL. 681-1141

PROJECT TITLE

**MONTGOMERY
PARK**

SHEET TITLE
IRRIGATION PLAN.

DRAWN <i>Wm. Evans.</i>	SHEET NO.
CHECKED <i>Wm. Evans.</i>	SHEET SIZE
DATE <i>SEPT. 26/96</i>	AI
SCALE <i>1:500</i>	DRAWING NO. 195-003

247381203
MICROFILMED

ICH 6470 A1 000